

HELLO@DTHREESTUDIO.CO.UK  
DTHREESTUDIO.CO.UK  
020 7096 9520

NOTES

DTHREE STUDIO DO NOT ACCEPT LIABILITY FOR ANY ERRORS AND OMISSIONS ARISING FROM THE PREPARATION OF BASE BUILD DRAWINGS WHICH ARE DERIVED FROM ORIGINAL MATERIAL PROVIDED BY OTHERS.  
ALL DISCREPANCIES ARE TO BE REPORTED TO DTHREE STUDIO.  
GRID LINES ARE FOR REFERENCE PURPOSES ONLY. ALL DIMENSIONS TO BE VERIFIED BY CONTRACTOR ON SITE PRIOR TO ANY WORKS COMMENCING. DO NOT SCALE FROM THIS DRAWING.  
THIS DOCUMENT IS THE PROPERTY OF DTHREE STUDIO.  
COPYRIGHT IS RESERVED BY THEM, AND THE DRAWING IS ISSUED ON THE CONDITION THAT IT IS NOT COPIED, REPRODUCED OR RETAINED BY, NOR DISCLOSED TO ANY UNAUTHORISED PERSON, EITHER WHOLLY OR IN PART, WITHOUT THE CONSENT IN WRITING FROM DTHREE STUDIO.

© DTHREE STUDIO



STATUS

- ☐ Approval / Comment
- ☐ Building Control
- ☐ Contract
- ☐ Construction
- ☒ As-Built

REVISION DETAIL

REV	DETAIL	BY	DATE
AB	AS BUILT ISSUE	EW	12.05.21

CLIENT

CBRE GI

PROJECT ADDRESS


9-10 WHITFIELD ST  
LONDON  
W1T 2RE

DRAWING TITLE

SECOND FLOOR  
GENERAL ARRANGEMENT

AS-BUILT

DWG NO:	29631-02-GA
REVISION:	AB
SCALE @A1:	1:50 @ A3: 1:100
DATE:	12.05.21
DRAWN BY:	CK
CHECKED BY:	CK

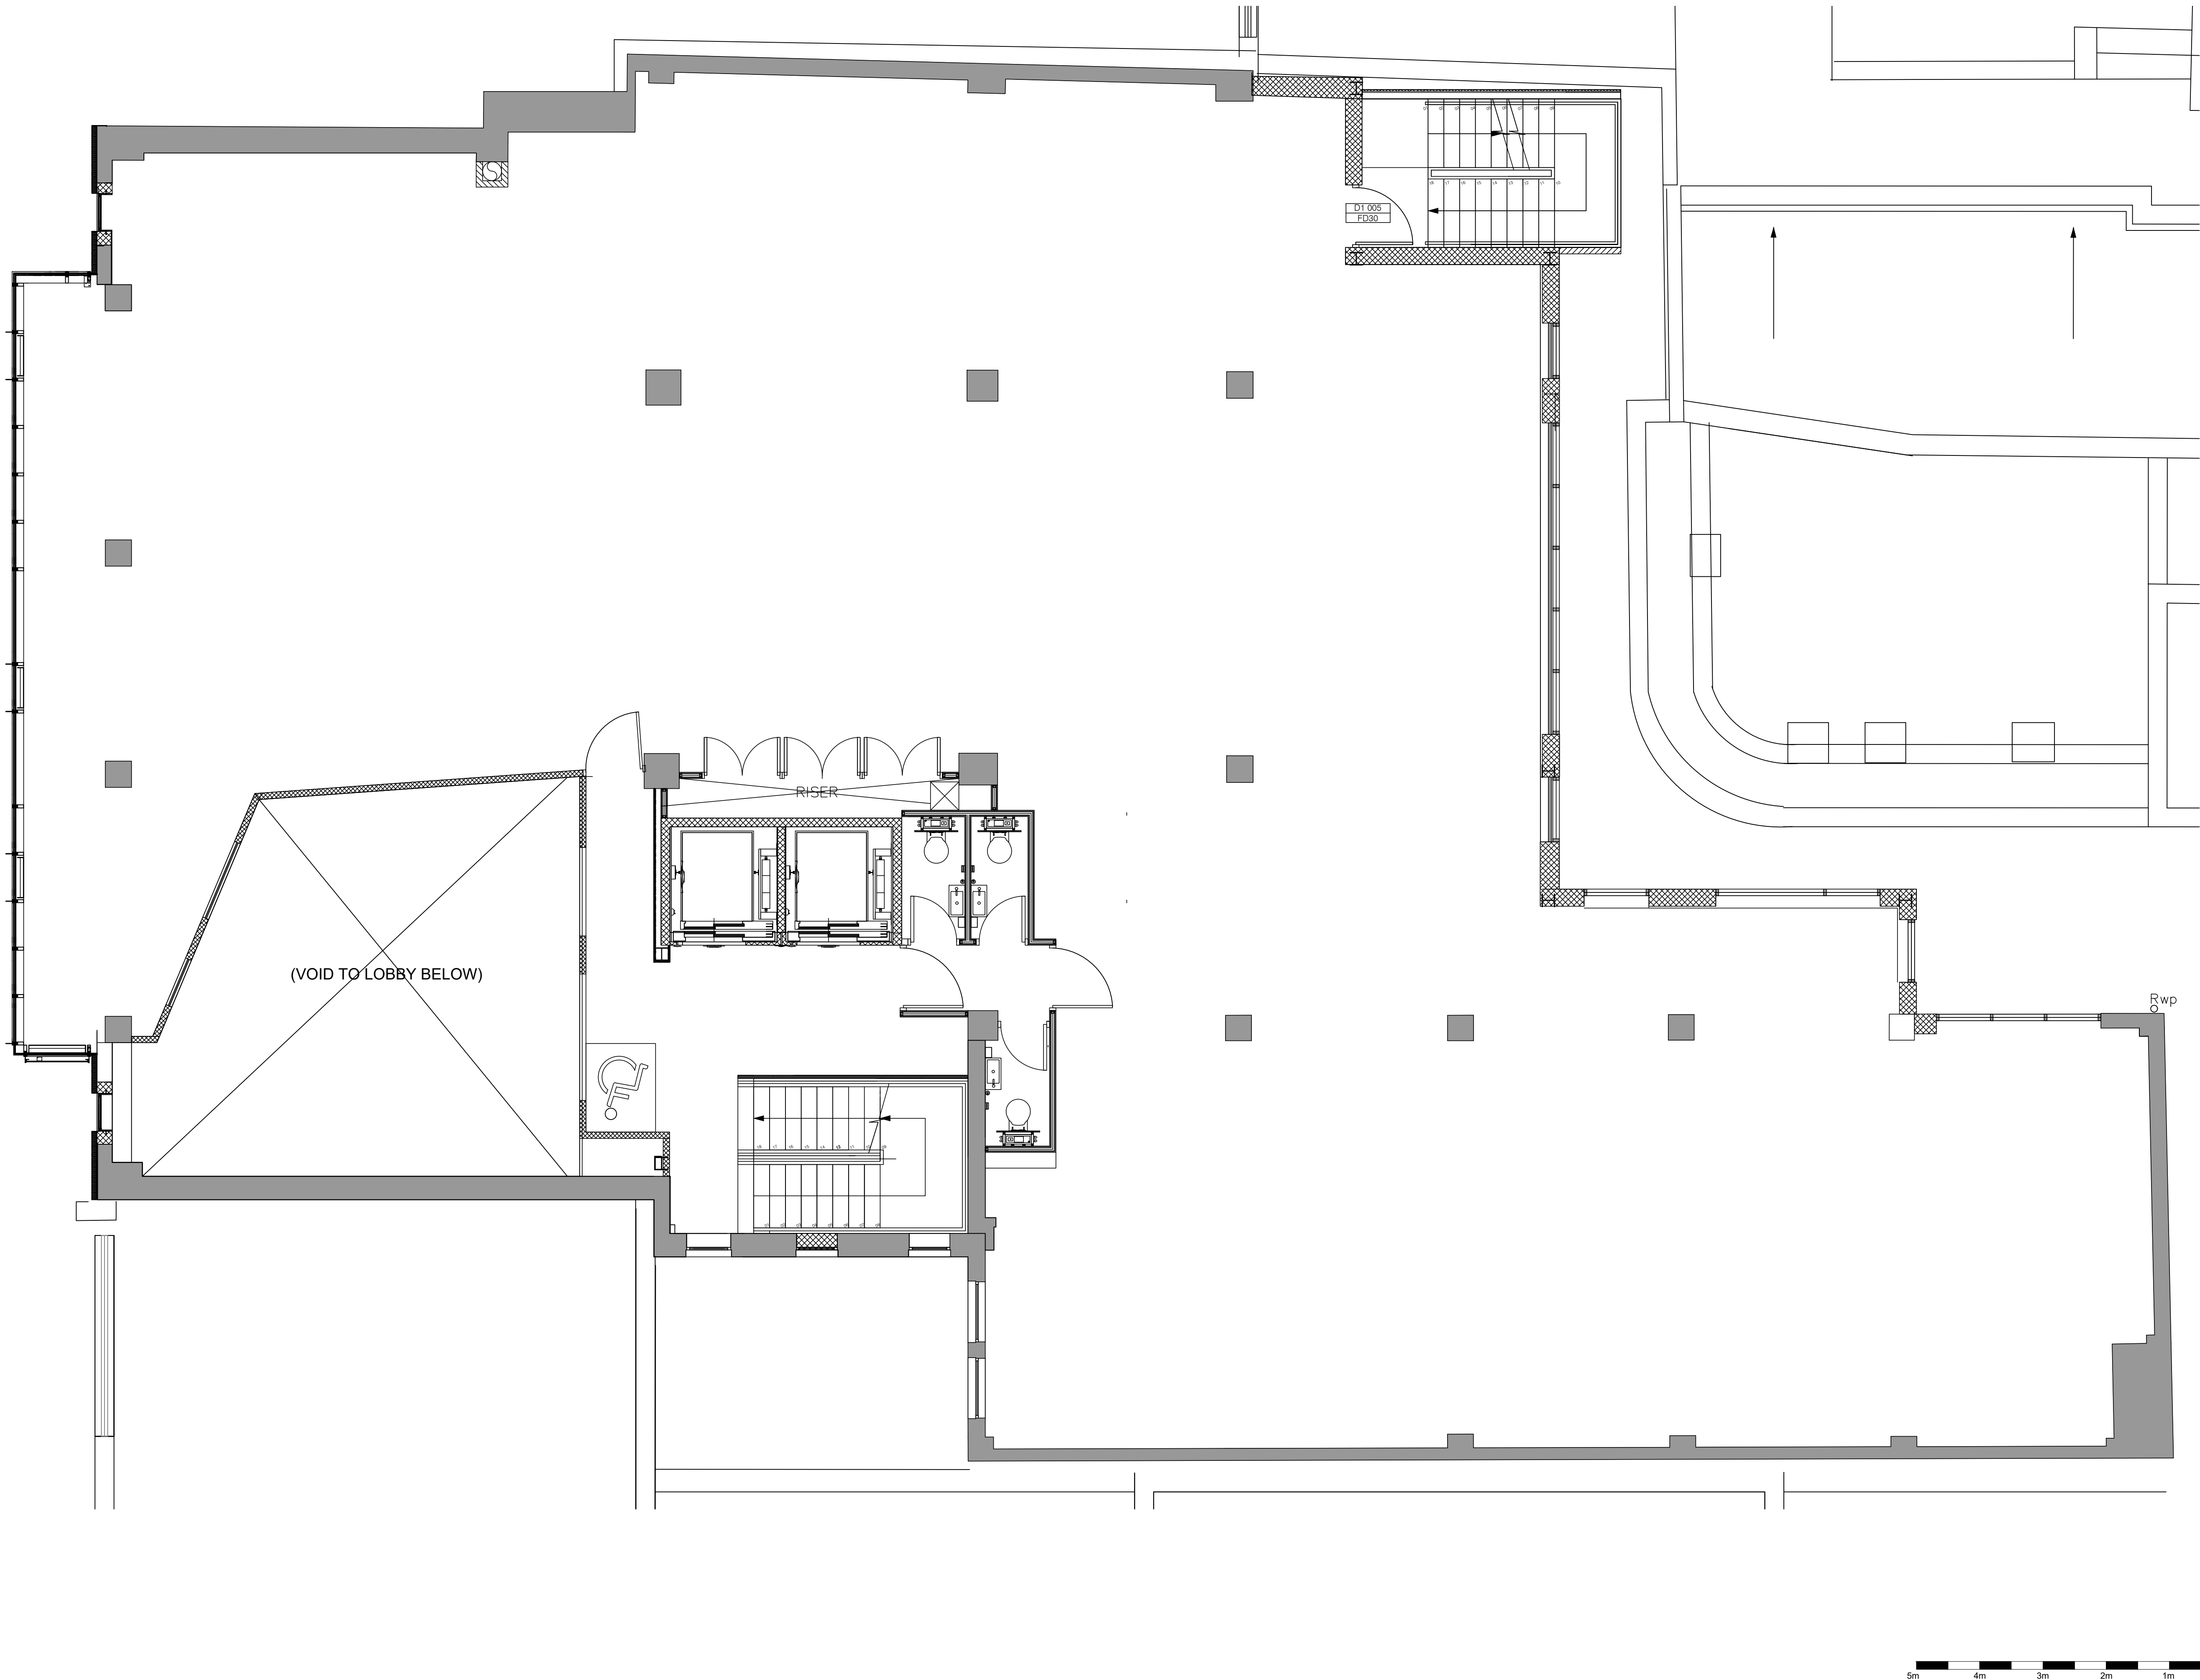

HELLO@DTHREESTUDIO.CO.UK  
DTHREESTUDIO.CO.UK  
020 7096 9520

NOTES

DTHREE STUDIO DO NOT ACCEPT LIABILITY FOR ANY ERRORS AND OMISSIONS ARISING FROM THE PREPARATION OF BASE BUILD DRAWINGS WHICH ARE DERIVED FROM ORIGINAL MATERIAL PROVIDED BY OTHERS.  
ALL DISCREPANCIES ARE TO BE REPORTED TO DTHREE STUDIO.  
GRID LINES ARE FOR REFERENCE PURPOSES ONLY. ALL DIMENSIONS TO BE VERIFIED BY CONTRACTOR ON SITE PRIOR TO ANY WORKS COMMENCING. DO NOT SCALE FROM THIS DRAWING.  
THIS DOCUMENT IS THE PROPERTY OF DTHREE STUDIO.  
COPYRIGHT IS RESERVED BY THEM, AND THE DRAWING IS ISSUED ON THE CONDITION THAT IT IS NOT COPIED, REPRODUCED OR RETAINED BY, NOR DISCLOSED TO ANY UNAUTHORISED PERSON, EITHER WHOLLY OR IN PART, WITHOUT THE CONSENT IN WRITING FROM DTHREE STUDIO.

© DTHREE STUDIO



STATUS

- Approval / Comment
- Building Control
- Contract
- Construction
- As-Built

REVISION DETAIL

REV	DETAIL	BY	DATE
P1	FIRST ISSUE	RS	26/04

CLIENT

CBRE GI


PROJECT ADDRESS

6-10 WHITFIELD ST  
LONDON

DRAWING TITLE

FIRST FLOOR  
GA PLAN  
WORKING DRAWING

DWG NO:	36952-01-GA
REVISION:	P1
SCALE @A1:	1:50 @ A3: 1:100
DATE:	26.04.21
DRAWN BY:	RS
CHECKED BY:	CK

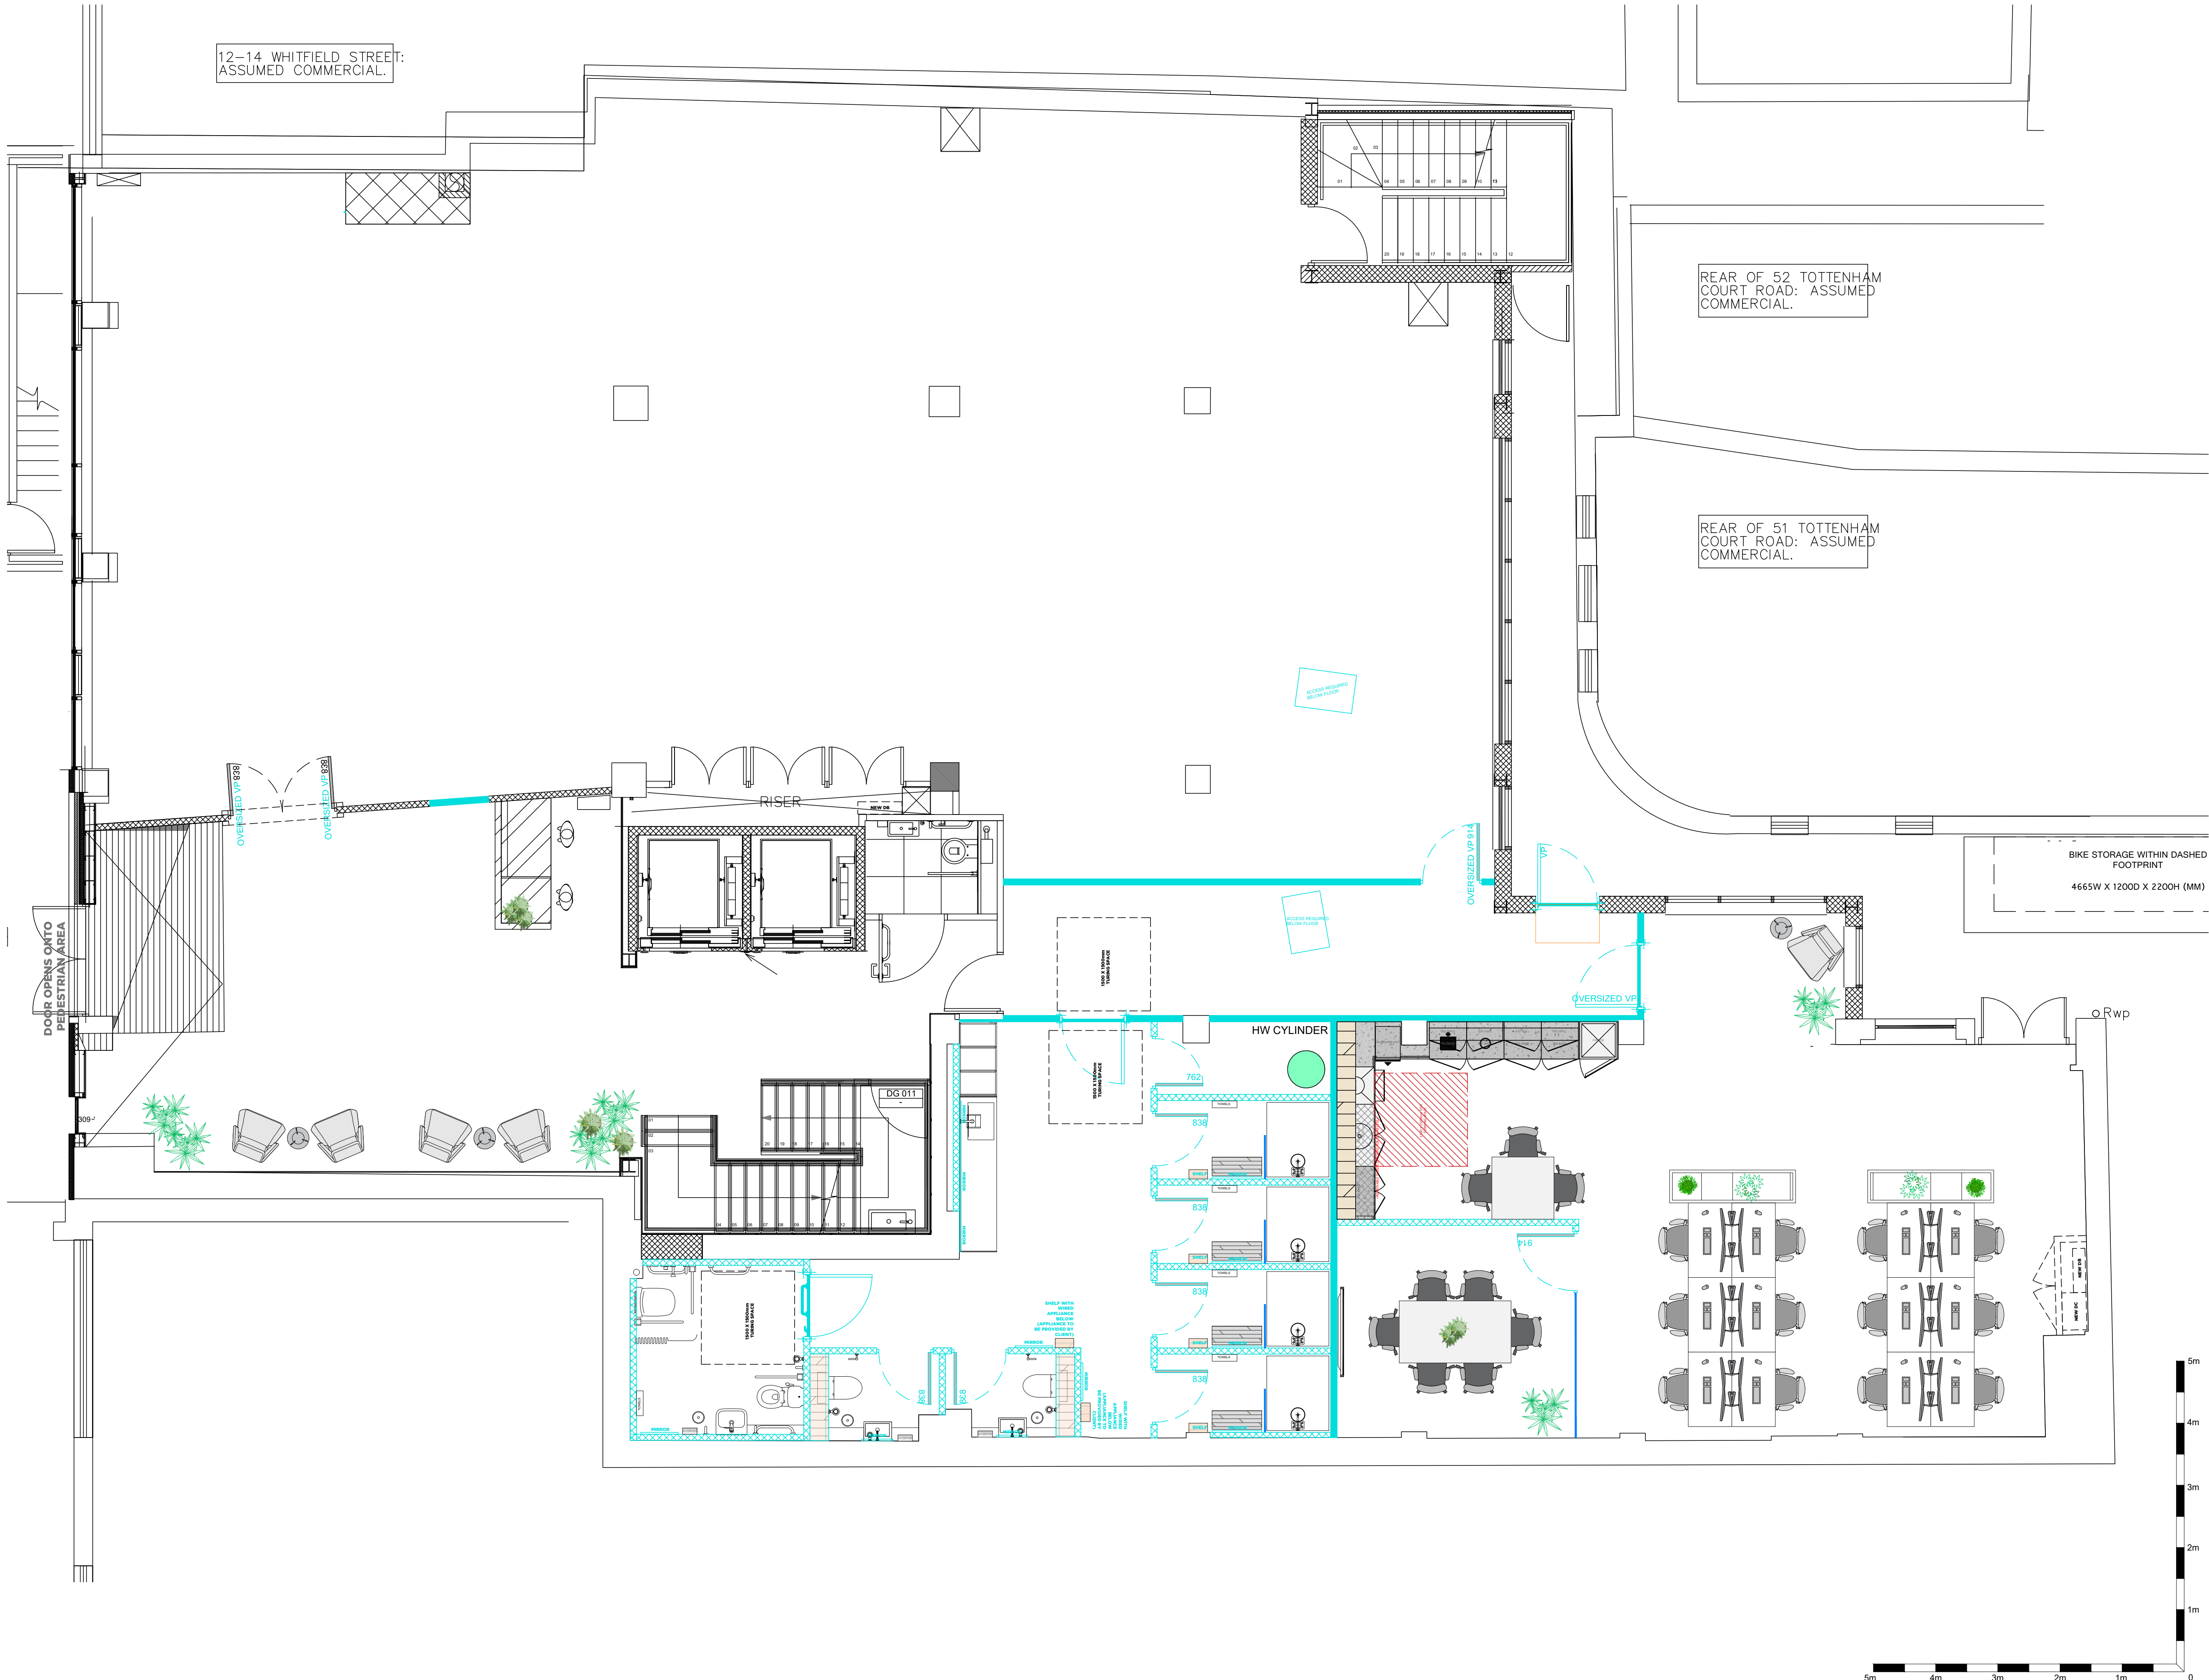

12-14 WHITFIELD STREET:  
ASSUMED COMMERCIAL.

REAR OF 52 TOTTENHAM  
COURT ROAD: ASSUMED  
COMMERCIAL.

REAR OF 51 TOTTENHAM  
COURT ROAD: ASSUMED  
COMMERCIAL.

ACCESS REQUIRED  
BELOW FLOOR

ACCESS REQUIRED  
BELOW FLOOR

OVERSIZED VP 834

OVERSIZED VP

BIKE STORAGE WITHIN DASHED  
FOOTPRINT  
4665W X 1200D X 2200H (MM)



HELLO@DTHREESTUDIO.CO.UK  
DTHREESTUDIO.CO.UK  
020 7096 9520

#### NOTES

DTHREE STUDIO DO NOT ACCEPT LIABILITY FOR ANY ERRORS AND OMISSIONS ARISING FROM THE PREPARATION OF BASE BUILD DRAWINGS WHICH ARE DERIVED FROM ORIGINAL MATERIAL PROVIDED BY OTHERS.  
ALL DISCREPANCIES ARE TO BE REPORTED TO DTHREE STUDIO.  
GRID LINES ARE FOR REFERENCE PURPOSES ONLY. ALL DIMENSIONS TO BE VERIFIED BY CONTRACTOR ON SITE PRIOR TO ANY WORKS COMMENCING. DO NOT SCALE FROM THIS DRAWING.  
THIS DOCUMENT IS THE PROPERTY OF DTHREE STUDIO.  
COPYRIGHT IS RESERVED BY THEM, AND THE DRAWING IS ISSUED ON THE CONDITION THAT IT IS NOT COPIED, REPRODUCED OR RETAINED BY, NOR DISCLOSED TO ANY UNAUTHORISED PERSON, EITHER WHOLLY OR IN PART, WITHOUT THE CONSENT IN WRITING FROM DTHREE STUDIO.

© DTHREE STUDIO



#### STATUS

- ☐ Approval / Comment
- ☐ Building Control
- ☐ Contract
- ☐ Construction
- ☒ As-Built

#### REVISION DETAIL

REV	DETAIL	BY	DATE
AB	AS BUILT ISSUE	EW	12.05.21

#### CLIENT

CBRE GI

#### PROJECT ADDRESS

9-10 WHITFIELD ST  
LONDON  
W1T 2RE

#### DRAWING TITLE

GROUND FLOOR  
GENERAL ARRANGEMENT  
**AS-BUILT**

DWG NO:	29631-00-GA
REVISION:	AB
SCALE @A1:	1:50 @ A3: 1:100
DATE:	12.05.21
DRAWN BY:	CK
CHECKED BY:	CK